

# Summary of Comments on Full page photo

---

Page: 1



---




Number: 1 Author: (b) (6)

Subject: Sticky Note Date: 8/28/2018 11:25:08


This is the existing wall prior to the renovation either by the customer or NAVFAC that opened the wall.

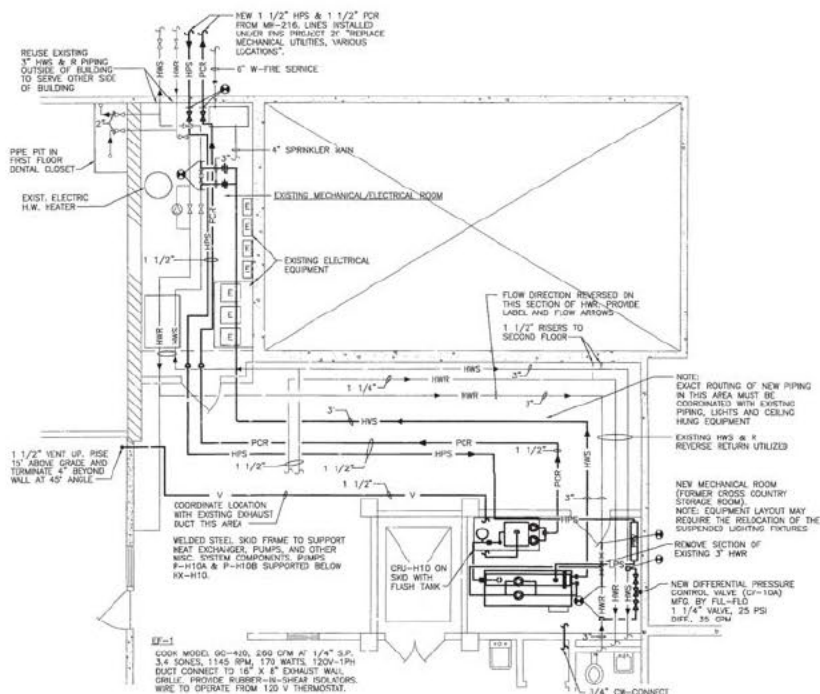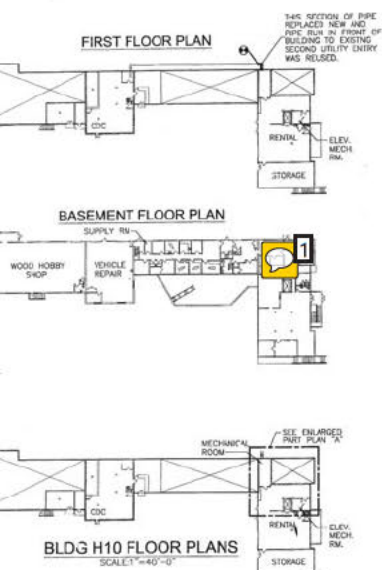

BLDG H10 ENLARGED BASEMENT PART PLAN "A"  
SCALE: 1/4" = 1'-0"

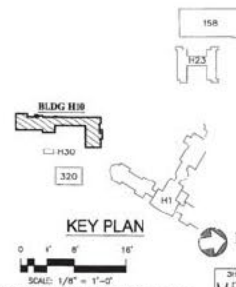

---

 Number: 1 Author: (b) (6) Subject: Sticky Note Date: 8/28/2018 11:27:14  
This shows the wall open between the two spaces

---